MEASUREMENT BOOK

Date	Full description, etc, of work	Dimensions				Contents	Reference to last Measurement
		Number	Length	Breadth	Depth		
1	2	3	4	5	6	7	8

I^st and Part Bill.

M. A. R. 57 (Rule 116)
Measurement Book

No. E 486707

Serial No. .....

"Cost Abstract"

Name of work ..... From ..... To .....

Name of Contractor of nature of Agency.....

Date of commencement of work.....

Date	Full description, etc, of work	Dimensions				Contents	Reference to last Measurement
		Number	Length	Breadth	Depth		
1	2	3	4	5	6	7	8
	Name of work :- Construction of cc road and other works at Shettyhalli Colony balance road ward No.12. Shettyhalli.						
	Estimated Cost :- Rs. 99.00 Lakhs.						
	Code sheet No :- 012-20-000013						
	Admin Approval :- No/BBMP/EE/DD/AS/ 167 2019-20 dtd 14.11.2019						
	Technical Sanction :- No/BBMP/D2/CE/SE/ 2019-20 dtd 16.11.2019						
	Contractor :- M/s KRIDL B'lore.						

08/03/21

MEASUREMENT BOOK

Date	Full description, etc, of work	Dimensions				Contents	Reference to last Measurement
		Number	Length	Breadth	Depth		
1	2	3	4	5	6	7	8
Sl No.	Description of Item.	Unit	Qty		Rate	Amount	Remarks
1	Dismantling.	Cum	251.10		413.40	103804.74	
2	EXE,	Cum	378.16		137.80	52110.45	
3	CC 1:3:6 Court.	Cum	23.25		5714.97	132873.05	
4	Removing & Resetting.	Sqm	871.20		208.82	181923.98	
5	Ruled pointing 20mm deep	Sqm	871.20		49.06	42741.07	
6	Covering Slab 10cm Thick	Sqm	536.40		1615.00	866286.00	
7	Dismantling CC pavement	Cum	373.35		952.94	355780.15	
8	Scarifying BC Court	Sqm	676.35		41.34	27960.31	
9	Scarifying metal Court	Sqm	2703.89		25.44	68786.96	
10	Compaction OGL	Sqm	2703.89		6.36	17196.74	
11	15MM	Cum	316.54		2001.28	633485.17	
12	DLC Court	Cum	316.54		3946.57	1248895.20	
13	PQC M30 Court	Cum	506.46		5354.02	2711597.97	

08/03/24

M. A. R. 57 (Rule 116)
Measurement Book

No. E 486708

Serial No. .....

Name of work ..... From ..... To .....

Name of Contractor of nature of Agency.....

Date of commencement of work.....

Date	Full description, etc, of work	Dimensions				Contents	Reference to last Measurement
		Number	Length	Breadth	Depth		
1	2	3	4	5	6	7	8
14	Kerbstone.	Nos	2448.88		435.84	1067324.22	
15	Kerb painting.	Sqm	175.00		84.80	14840.00	
16	Unserviable Removal	Cum	378.16		34.98	13228.06	
17	Loading & unloading	Cum	725.90		57.00	41376.30	
18	Handing	Cum	1104.06		56.32	62180.66	
19a)	Foundation fully 40mm jelly.	Cum	1.87		1901.00	3554.87	
b)	20mm Jelly	Cum	1.87		1901.00	3554.87	
c)	Course Sand	Cum	1.40		2651.00	3711.40	
d)	Fine sand	Cum	0.90		2651.10	2451.96	
e)	12.5mm Chips.	Cum	1.40		1901.00	2661.40	
20	HDPE Pipe	Rmt	27.00		108 22.32	292202.64	

08/03/24

MEASUREMENT BOOK

Date	Full description, etc, of work	Dimensions				Contents	Reference to last Measurement
		Number	Length	Breadth	Depth		
1	2	3	4	5	6	7	8
~~25~~	Geonets	Sqm	4.68	71.03		332.42	
~~26~~				Total		79503799.55	
	Add 12% GST					9540455.95	
	Add KRIDL chgs 4%					318023.98	
				Grand Total =		9222695.47	

ಸಹಾಯಕ ಕಾರ್ಯಪಾಲಕ ಅಭಿಯಂತರರು
ಬೆಟ್ಟಹಳ್ಳಿ ಉಪವಿಭಾಗ, ನಾಸರಹಳ್ಳಿ ಪಲಯ
ಬೃಹತ್ ಬೆಂ... ಮಹಾನಗರ ಪಾಲಿ
ಎಸ್.ಎಂ. ರಸ್ತೆ, ಆನಂದನಗರ, ಬೆಂಗಳೂರು

M. A. R. 57 (Rule 116)
Measurement Book

486709

Serial No. .....
Name of work ..... From .....
Name of Contractor of nature of Agency.....
Date of commencement of work.....

Date	Full description, etc, of work	Dimensions				Contents	Reference to last Measurement
		Number	Length	Breadth	Depth		
1	2	3	4	5	6	7	8
	Audited and admitted for Rs. 9222695-47 Passed by Cheque for Rs. 8138159-00 (Rupees Eight One Lakh Fifty one-Thousand One Hundred Seventy Six only) by C.084536/107119 = 0				Gross	9222695 P.O 84536 8138159	

Asst. Engineer
Exe. Engineer
B.B.M.P. Basavanahalli Division

MEASUREMENT BOOK

Date	Full description, etc, of work	Dimensions				Contents	Reference to last Measurement
		Number	Length	Breadth	Depth		
1	2	3	4	5	6	7	8

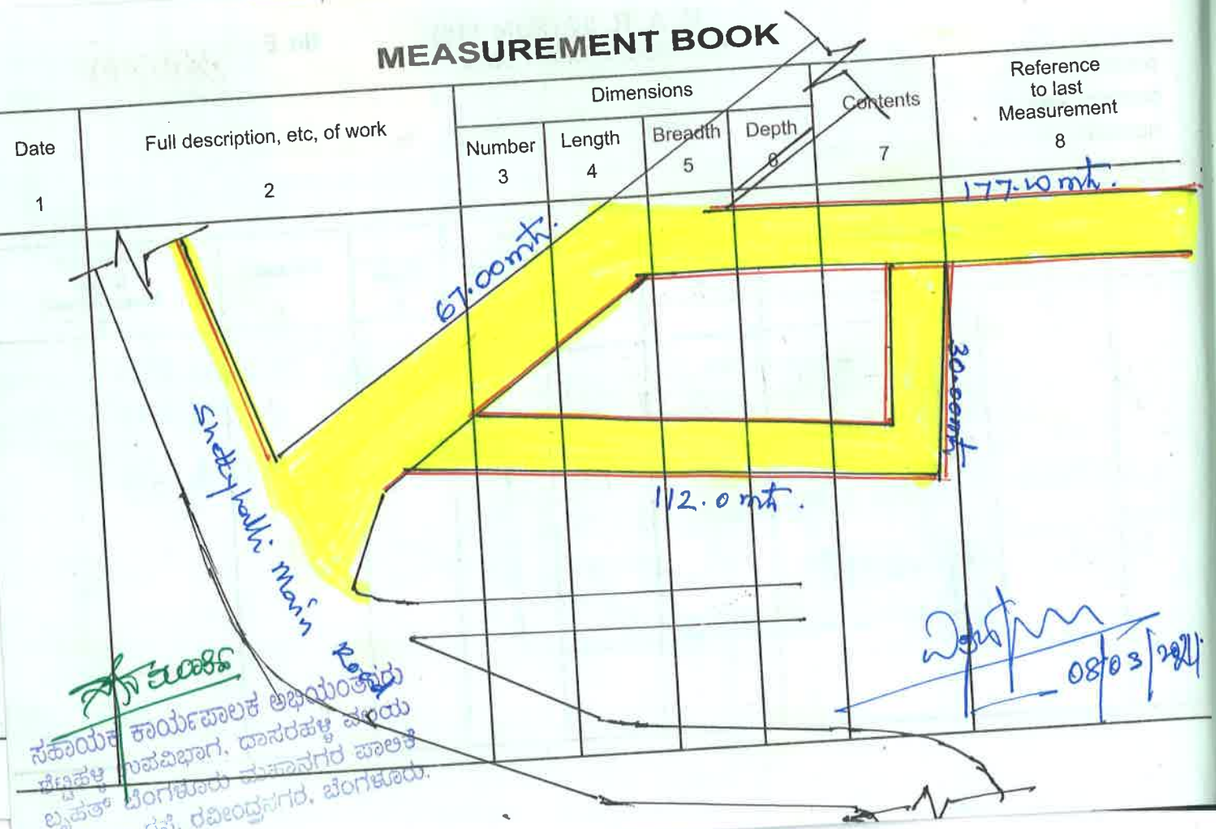

ಸಹಾಯಕ ಕಾರ್ಯಪಾಲಕ ಅಭಿಯಂತರರು
ಜೆಟ್ಟಿಹಳ್ಳಿ ಉಪವಿಭಾಗ, ದಾಸರಹಳ್ಳಿ ವಲಯ
ಬೃಹತ್ ಬೆಂಗಳೂರು ಮಹಾನಗರ ಪಾಲಿಕೆ
ಎಸ್.ಎಂ. ರಸ್ತೆ, ರವೀಂದ್ರನಗರ, ಬೆಂಗಳೂರು.

08/03/2021

M. A. R. 57 (Rule 116)
Measurement Book

No. E 486710

Serial No. .....

Name of work ..... From ..... To .....

Name of Contractor of nature of Agency.....

Date of commencement of work.....

Date	Full description, etc, of work	Dimensions				Contents	Reference to last Measurement
		Number	Length	Breadth	Depth		
1	2	3	4	5	6	7	8